


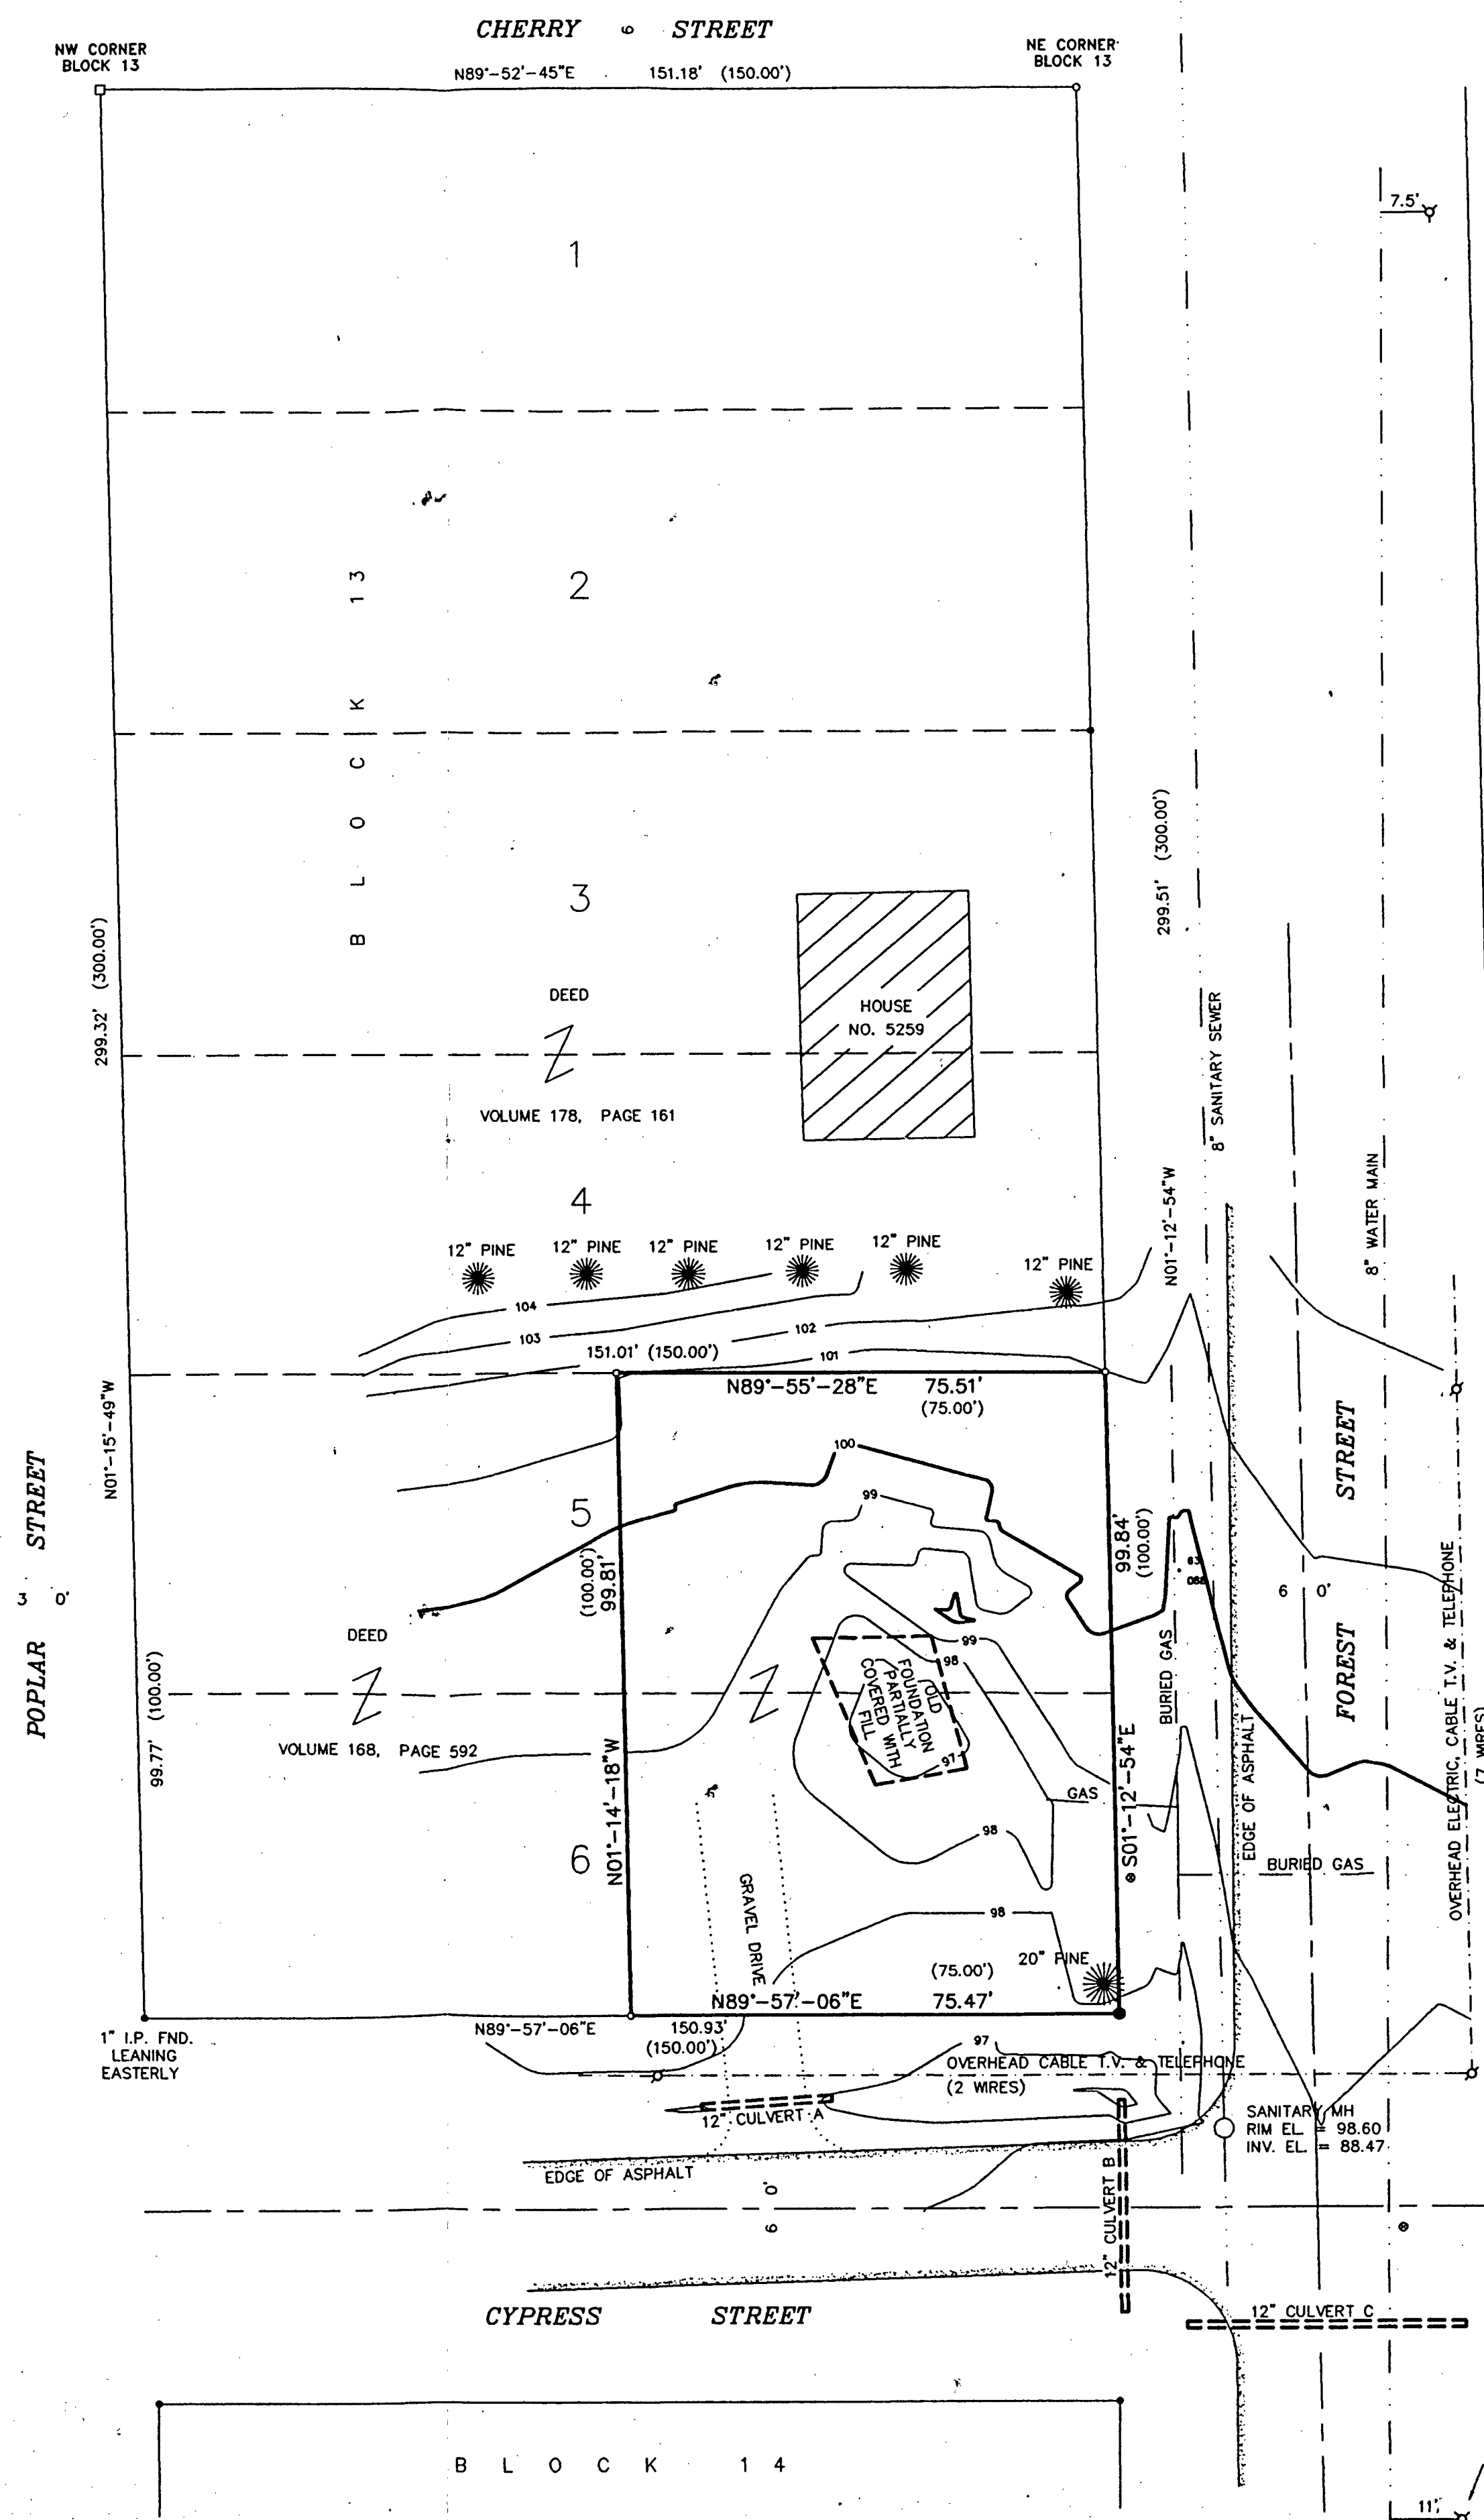

DESCRIPTION

The East Half (E½) of Lots Five (5) and Six (6), Block Thirteen (13), Third (3RD) Railway Addition, A subdivision being a part of the Northwest Quarter (NW¼) of Section Thirty-One (31), Township Thirty-Six (36) North, Range Fifteen (15) East, Town of Laona, Forest County, Wisconsin.

Deed recorded in Volume 178, Page 373.
Tax Key No: 18 420000.013.005

Surveyed for: The Staubach Company
Corporate Alliance Division
6750 LBJ Freeway, Suite 1100
Dallas, Texas 75240
(214) 716-6330

GTE
1312 East Empire Blvd.
Bloomington, Illinois 61701

SURVEYOR'S CERTIFICATE

I, Anthony P. Lulloff, Wisconsin Registered Land Surveyor of Aero-Metric, Inc., certify that I have surveyed the described property and that the map shown is a true and accurate representation thereof to the best of my knowledge and belief.


Dated this 4th day of August, 1996.

Anthony P. Lulloff
WISCONSIN REGISTERED LAND SURVEYOR
Anthony P. Lulloff, S-1655



- FLOW LINE ELEVATIONS
- 12" CULVERT A
WEST FLOW LINE ELEV. = 96.93'
EAST FLOW LINE ELEV. = 96.78'
 - 12" CULVERT B
NORTH FLOW LINE ELEV. = 95.52'
SOUTH FLOW LINE ELEV. = 94.95'
 - 12" CULVERT C
WEST FLOW LINE ELEV. = 94.48'
EAST FLOW LINE ELEV. = 95.40'
- LEGEND -
- = 1"x24" IRON PIPE SET
 - = 2" IRON PIPE FOUND
 - = 1" IRON PIPE FOUND
 - △ = "P.K." MASONRY NAIL FOUND/SET
 - ⊙ = COUNTY MONUMENT FOUND
 - () = RECORDED INFORMATION
 - ⚡ = HYDRANT
 - ⊕ = WATER VALVE
 - ⊖ = GAS VALVE
 - = 6" NAIL SET
 - ⌘ = POWER POLE

NOTE: LOCATION OF 8" WATER MAIN IS PER INFORMATION PROVIDED BY THE LAONA SANITARY DISTRICT

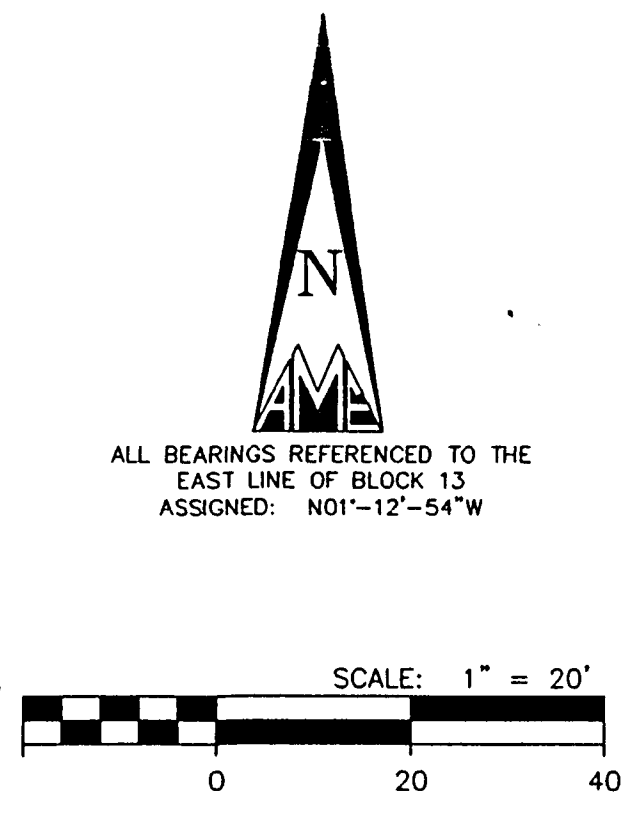

DATE : 09-03-96 SCALE : 1"=20'

REVISIONS :

DRAWN BY : S.F.S. CHECKED BY : A.P.L.

DWG. FILE : GTE-LAONA

PROJECT NO. : 2960823

NOTEBOOK : P-187 PAGE : 10-14

AERO-METRIC
Aero-Metric, Incorporated
Land Planning & Design Division
414-849-7788 800-472-3333 FAX (414)-7789
539 NORTH MADISON STREET CHILTON, WISCONSIN 53014

Only if the surveyor's signature or stamp is in RED is this an original copy. Anything other than an original copy may contain unauthorized alterations to the original.

The surveyor accepts no responsibility for non-original copies of this document.

SITE SURVEY FOR

GTE NORTH AND THE STAUBACH CO.

OF THE E½ OF LOTS 5 & 6, BLOCK 13, 3RD RAILWAY ADDITION, A SUBDIVISION BEING A PART OF THE NW¼ OF SECTION 31, T.36N., R.15E., TOWN OF LAONA, FOREST COUNTY, WISCONSIN.

SHEET NO.
1 OF 1

FILE NO.
K-27015